

480 & 510 E Wilson Bridge Rd
Worthington, OH 43085

For Lease



OFFICE/FLEX MULTI-TENANT PROPERTY

Lease Rate:

\$11.95 - \$12.95 PSF Net

Available Office/Flex Space:

480 Building:

Suite D: 2,045 SF

Suite H: 4,125 SF

510 Building:

Suite C: 4,100 SF

Suite D: 5,000 SF

*Total Contiguous: 9,100 SF

- Easy access to I-270, SR 315 and I-71.
- 3 building complex on 11 acres .
- Access to complex on both E Wilson Bridge and Worthington Galena Roads.
- Flex space offers 16' ceiling height and 10' drive in doors.
- Tenant signage above suite entrances.
- Ample parking in front and rear of buildings.
- Excellent Worthington location in close proximity to restaurants, services and shopping.



Jackson Pulliam
614.545.4097
jpulliam@AlterraRE.com

Richard Conie
614.545.4099
rconie@AlterraRE.com

Alterra Real Estate
614.365.9000
www.AltterraRE.com

480 & 510 E Wilson Bridge Rd
Worthington, OH 43085

Available Suites

Suites	RSF	Comments
480 - D	2,045	Office/warehouse with 1 overhead door.
480 - H	4,125	Office/warehouse with 2 drive-in doors and 2 restrooms
510 - C	4,100	Office/warehouse with 1 overhead door.
510 - D	5,000	Office/warehouse with 1 overhead door.

*510 C & D contiguous for a total of: 9,100 SF



Jackson Pulliam
614.545.4097
jpulliam@AlterraRE.com


Richard Conie
614.545.4099
rconie@AlterraRE.com

Alterra Real Estate
614.365.9000
www.AlterraRE.com

480 & 510 E Wilson Bridge Rd
Worthington, OH 43085

Available Suites

Suite 480 D
2,045 SF

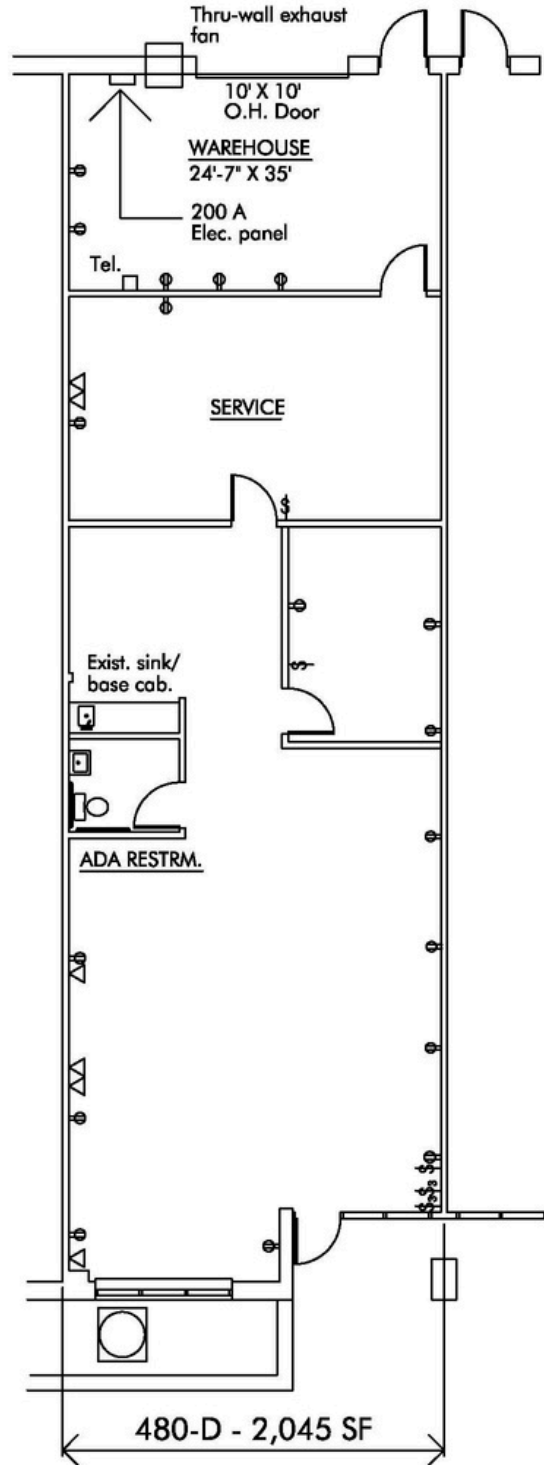

Jackson Pulliam
614.545.4097
jpulliam@AlterraRE.com


Richard Conie
614.545.4099
rconie@AlterraRE.com

Alterra Real Estate
614.365.9000
www.AltterraRE.com

480 & 510 E Wilson Bridge Rd
Worthington, OH 43085

Available Suites

Suite 480 H
4,125 SF

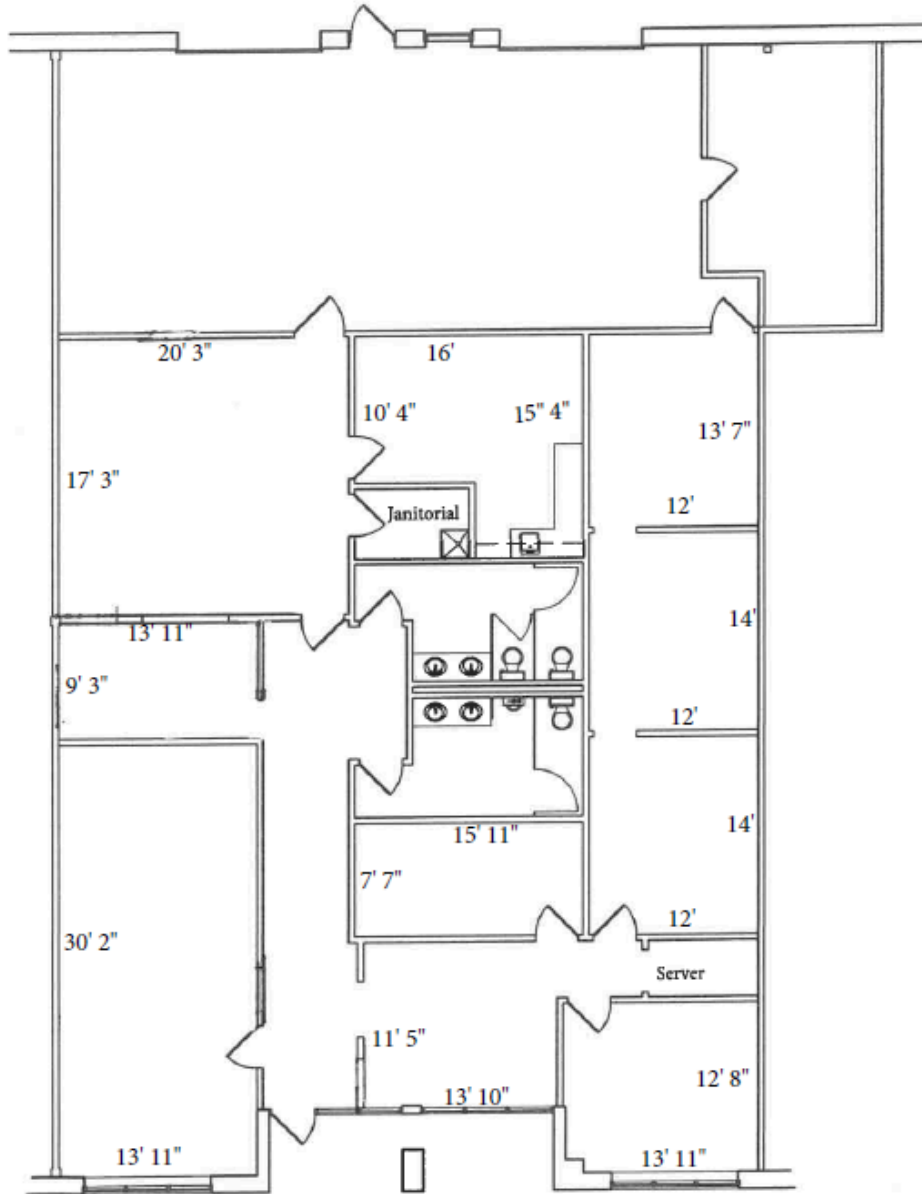

Floor Plan

N.T.S.



5880 Wilson Plaza
Suite J
Dublin, OH 43016
Ph: 614-702-1000
Fax: 614-702-1320
mail@carneyranker.com

Asbuilt for

480 E. Wilson Bridge Road, Suite H

480 E. Wilson Bridge Road

Worthington, Ohio

AB-1

14246.190



Jackson Pulliam
614.545.4097
jpulliam@AlterraRE.com

Richard Conie
614.545.4099
rconie@AlterraRE.com

Alterra Real Estate
614.365.9000
www.AltterraRE.com

480 & 510 E Wilson Bridge Rd
Worthington, OH 43085


Available Suites

Suite 510 C 4,100 SF



Building Key Plan

NTS

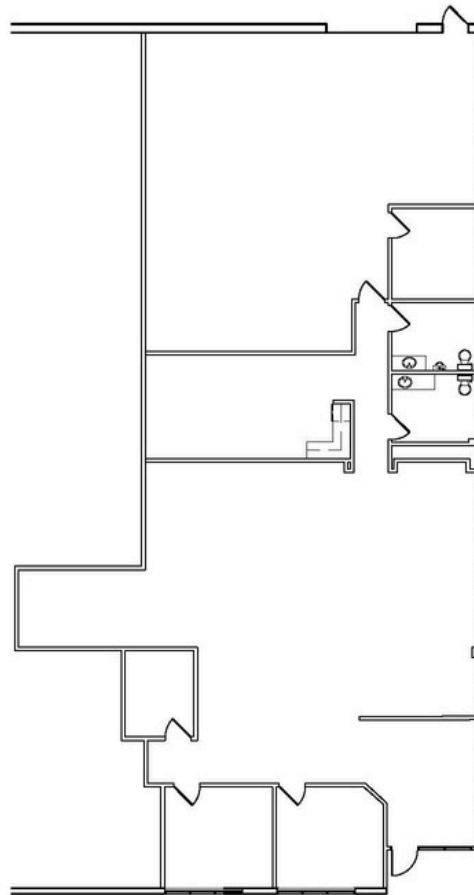

Suite 510 C

1/16" = 1'-0"



Jackson Pulliam
614.545.4097
jpulliam@AlterraRE.com

Richard Conie
614.545.4099
rconie@AlterraRE.com

Alterra Real Estate
614.365.9000
www.AltterraRE.com

480 & 510 E Wilson Bridge Rd Worthington, OH 43085

Available Suites

Location Facts & Demographics

Demographics are determined by a 10 minute drive from 510 E Wilson Bridge Rd, Worthington, OH 43085

CITY, STATE

Worthington, OH

POPULATION

87,849

AVG. HHSIZE

2.33

MEDIAN HH INCOME


\$67,797

HOME OWNERSHIP

Renters: **15,902**

Owners: **21,923**

EMPLOYMENT

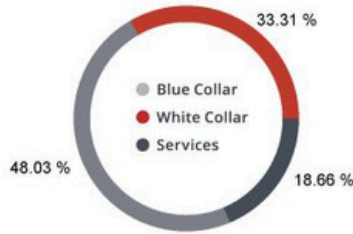


54.92%
Employed

1.26%
Unemployed

GENDER & AGE

48.84% **51.16%**

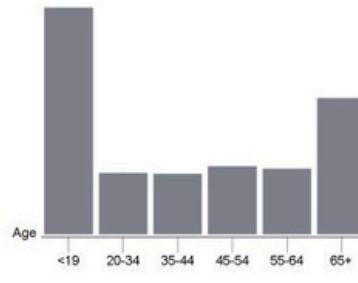

RACE & ETHNICITY


White:	76.69%
Asian:	3.31%
Native American:	0.02%
Pacific Islanders:	0.00%
African-American:	8.09%
Hispanic:	6.56%
Two or More Races:	5.33%

EDUCATION



High School Grad:	17.76%
Some College:	21.76%
Associates:	6.94%
Bachelors:	51.72%

Catylist Research

INCOME BY HOUSEHOLD

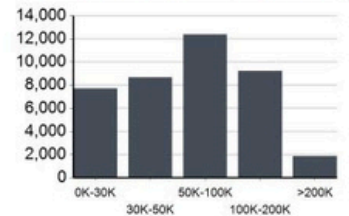

HH SPENDING

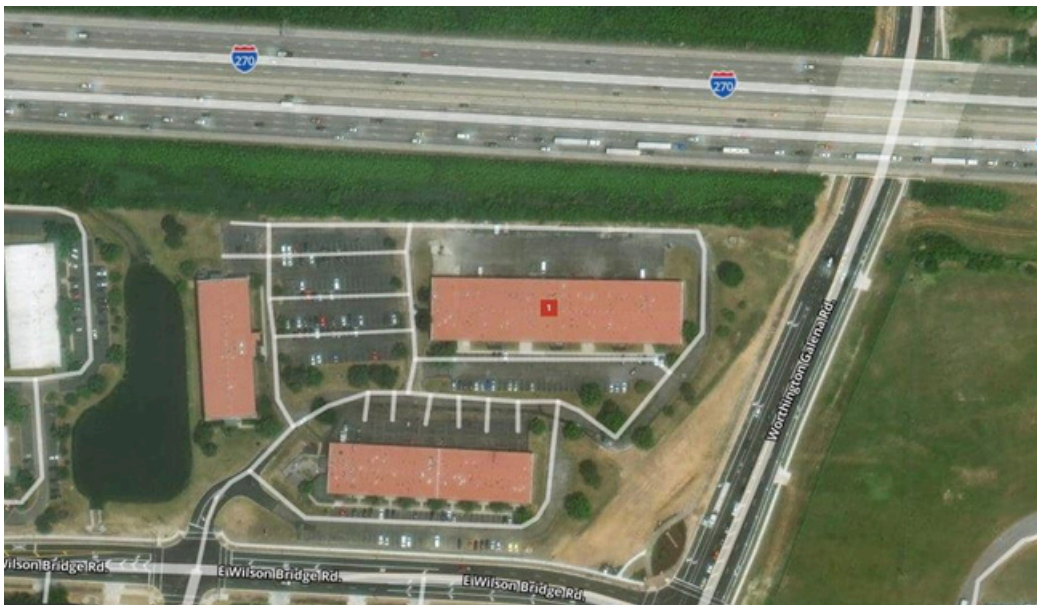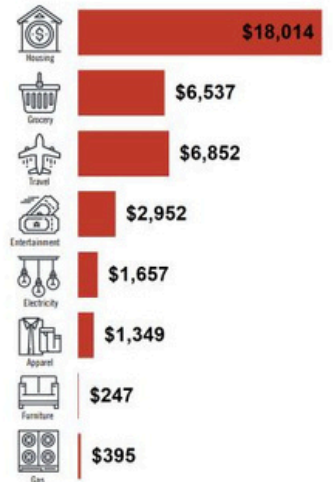

Jackson Pulliam
614.545.4097
jpulliam@AlterraRE.com

Richard Conie
614.545.4099
rconie@AlterraRE.com

Alterra Real Estate
614.365.9000
www.AltterraRE.com